

HMO Occupancy

Total Number of Let rooms/units: 5
Maximum Number of People: 5
Licence Number: 19/0298/HMO18

S & S – 'strips & Seals' = intumescent strips & cold smoke seals

SL – 'security lock' = of a type that does not require a key to unlock from the inside

SC – 'self closer' = self closer that fully closes the door into the rebate, when released from anywhere within the arc, overcoming the latch

Doors & walls (loft hatches – LH & underside of stairs 'UD') drawn in red are required to provide 30min fire protection


See separate key overleaf.

Some works such as additional bathrooms / ensuites, alterations to walls etc require building regulations – contact: BCcontrol@swindon.gov.uk

Planning Permission may be required in certain circumstances including: 7 or more tenants & self contained lets - contact: PlanningEnquiries@swindon.gov.uk

Property: 3 Cameron Close, Swindon, SN3 4PF

Drawn: CAOW
Date : 16/04/2019
Scale: Not to scale
Healthy Neighbourhoods, Swindon Borough Council
Beckhampton Street, Swindon, SN1 2JH
Tel : 01793 445500
Email: healthyneighbourhoods@swindon.gov.uk

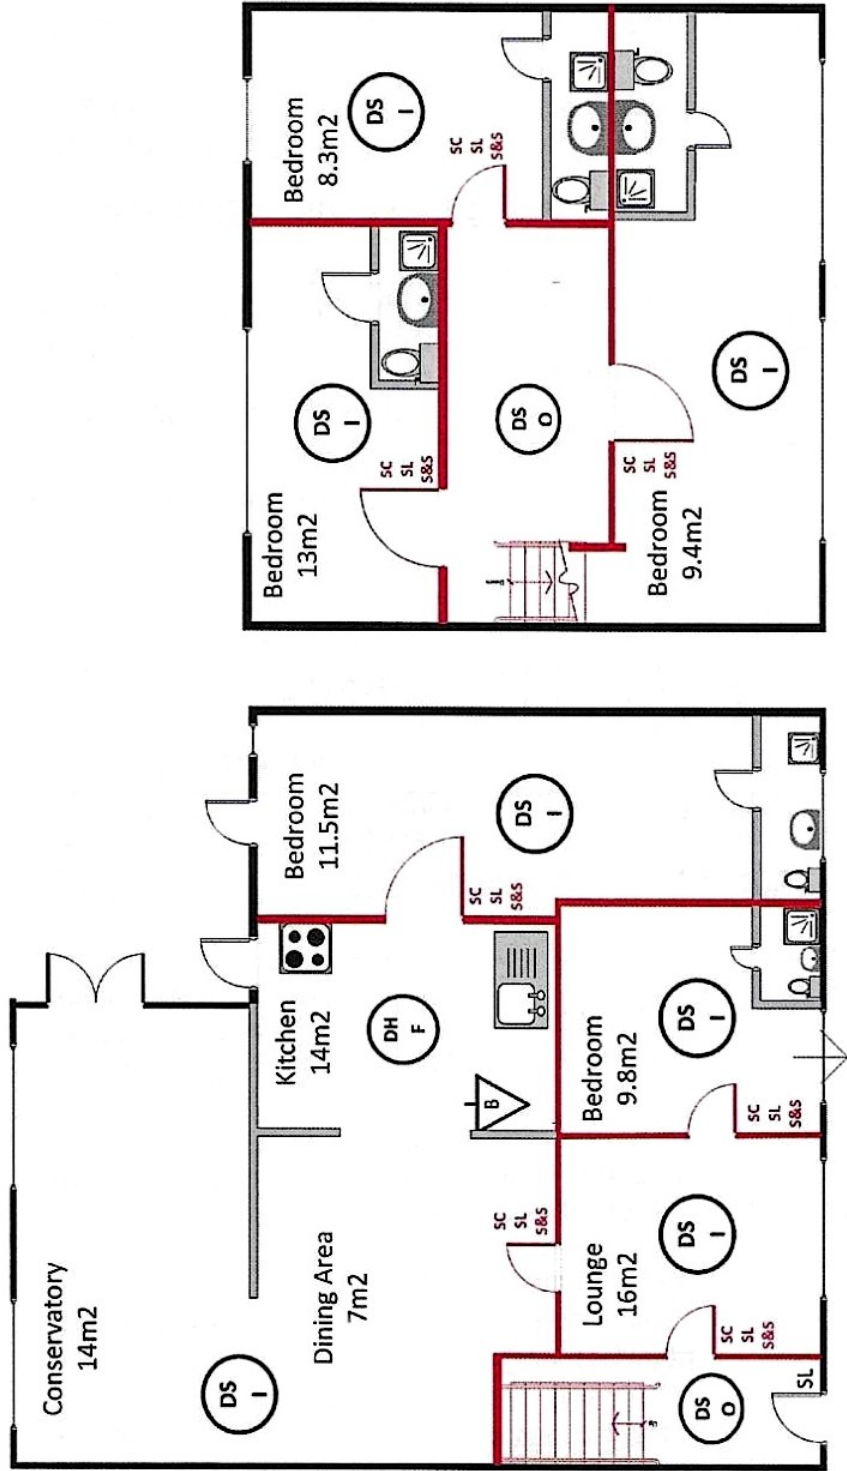

First Floor

Ground Floor